



EXPRESS MAIL NO. EV170132831US

IN THE UNITED STATES PATENT AND TRADEMARK OFFICE

Applicants : Giampiero Maggioni et al.
Application No. : 09/740,737
Filed : December 18, 2000
For : LOOP-TYPE VOLTAGE REGULATING DEVICE

Examiner : Julio C. Gonzalez
Art Unit : 2834
Docket No. : 856063.677
Date : September 12, 2002

Commissioner for Patents
Washington, DC 20231

REQUEST FOR DRAWING CHANGE

Commissioner for Patents:

Drawing changes, as indicated in red on the attached drawing, are hereby submitted for approval by the Examiner.

Respectfully submitted,
Giampiero Maggioni et al.
Seed Intellectual Property Law Group PLLC

E. Russell Tarleton
E. Russell Tarleton
Registration No. 31,800

ERT:aep

Enclosures:

Redlined Figures 5

701 Fifth Avenue, Suite 6300
Seattle, Washington 98104-7092
Phone: (206) 622-4900
Fax: (206) 682-6031

D:\NrPortbl\iManage\ATHENAP\317201_1.DOC

PATENT

#11/11/02 to the
draftsman
J. Evans
9-19-02

RECEIVED
SEP 19 2002
TECHNOLOGY CENTER 2800

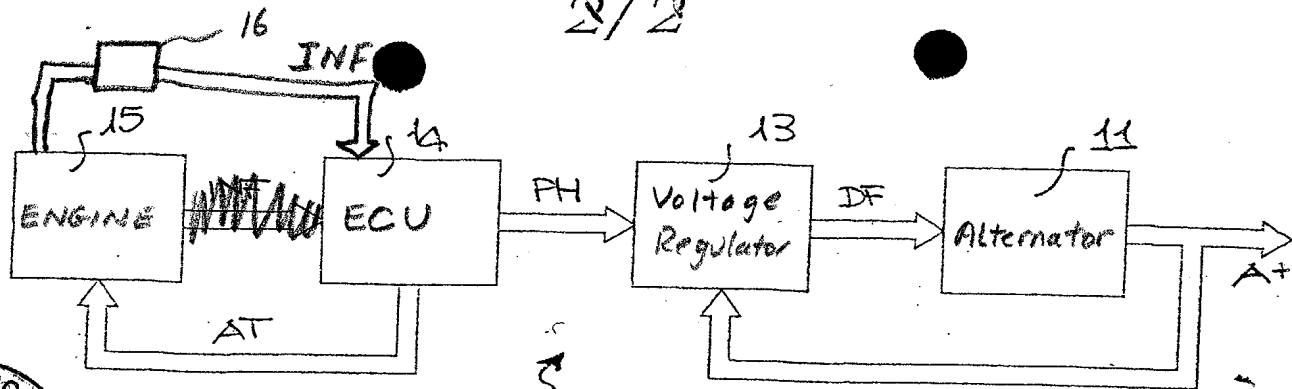


FIG. 5

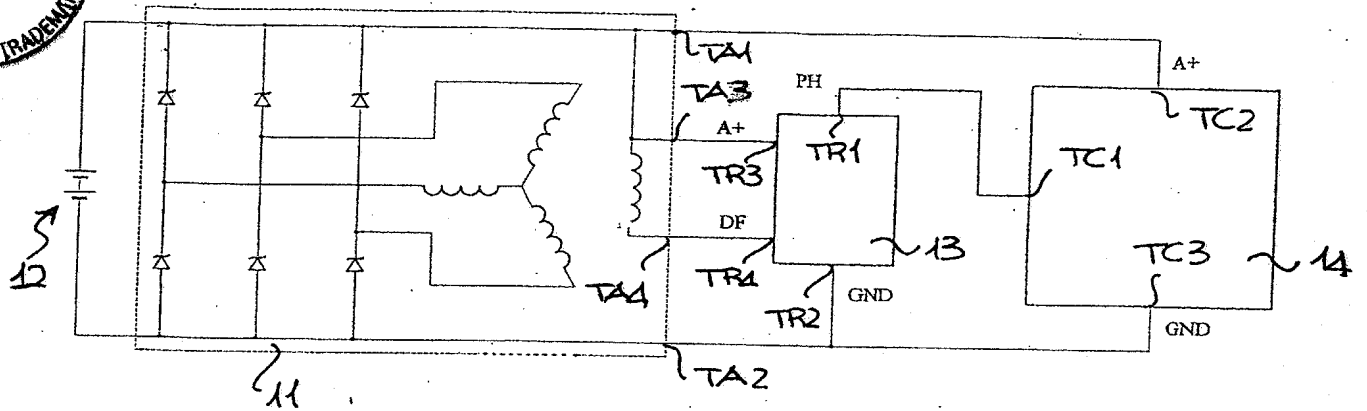


FIG. 4



RECEIVED
SEP 19 2002
TECHNOLOGY CENTER 2800